

LABOR AND MATERIALS


Copper	} Connection		\$		
Lead					
Curb	} Cock Valve T.S. & V. }	in.	\$		
				Service box	} Short 3½ x 4½ } Long 4½ x 5½ }
7 Ft. 3/4 in.	} Copper G.I. C.I. }	Pipe at	\$		
Nipples		in. at	\$		
Bushings	to in. at	\$			
Red'g } Inc'g }	} Coupl'gs	to in. at	\$		
Union		in. at	\$		
Meter	in. at	\$			
Compound Joints	at	\$			
Maintenance Foreman		\$			
Hrs. Water Maint. Man—1	at	\$			
Hrs. Water Maint. Man—2	at	\$			
Hrs. Garage Foreman	at	\$			
Hrs. Labor—	at	\$			
Hrs. Compressor	at	\$			
Trucking		\$			
Pav't Patch		\$			
		\$			
		\$			
FULTON

St.
 Pt.
 Ave. No. 14

Name of Owner
 TAX ID # 302.16-20-25

Labor and Mat'l. Report 19 22

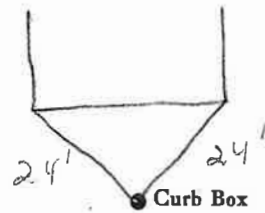

Main Elev. of Main at tap
 Gate at • Gate at

• Curb Box

NOTE - 2 curb stops at this address - stop closest to house is the active