


LABOR AND MATERIALS

1	Copper lead	Connection	$\frac{3}{4}$	\$	
1	Curb	Cock Wedge T.S. & V.	$\frac{3}{4}$ in.	\$	
1	Service box Old returned	{ Short 3-1/2 x 4-1/2 Long 4-1/2 x 5-1/2 }		\$	
23	Ft.	$\frac{3}{4}$ in. { Copper Gal. Gal. }	Pipe at	\$	
	Nipples		in. at	\$	
	Bushings		to in. at	\$	
	Red'g				
	Inc'g				
	Union		in. at	\$	
	Meter		in. at	\$	
				\$	
	Compound Joints	at		\$	
	Maintenance Foreman			\$	
	Hrs. Water Maint. Man - 1	at		\$	
	Hrs. Water Maint. Man - 2	at		\$	
	Hrs. Garage Foreman	at		\$	
	Hrs. Labor	at		\$	
	Hrs. Compressor	at		\$	
				\$	
	Trucking			\$	
	Pav't Patch			\$	
				\$	
				\$	
St. FULTON No. 15
 Name of Owner _____

Labor and Mat'l. Report 19 29, SEPT. 10

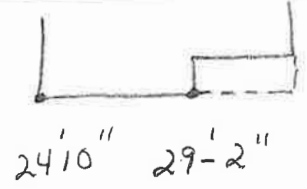

● Curb Box

10\" Main Elev. of Main at tap 4 1/2'

Gate at ● Gate at

TAX ID # 3302.20-10-12

● Curb Box

OLD TAP DISCONNECTED