

LABOR AND MATERIALS


1 Copper } Connection $\frac{3}{4}$ \$ _____
~~Lead~~
 1 Curb } Cock } $\frac{3}{4}$ in. \$ _____
 Valve }
 T.S. & V. }
 1 Service box { Short $3-1/2 \times 4-1/2$ } \$ _____
 Old returned { Long $4-1/2 \times 5-1/2$ }
 24 Ft. $\frac{3}{4}$ in. { Copper } Pipe at _____ \$ _____
 Nipples _____ in. at _____ \$ _____
 Bushings _____ to _____ in. at _____ \$ _____
 Red'g _____
 Inc'g _____
 Union _____ in. at _____ \$ _____
 Meter _____ in. at _____ \$ _____
 _____ \$ _____
 Compound Joints at _____ \$ _____
 Maintenance Foreman _____ \$ _____
 Hrs. Water Maint. Man - 1 at _____ \$ _____
 Hrs. Water Maint. Man - 2 at _____ \$ _____
 Hrs. Garage Foreman _____ at _____ \$ _____
 Hrs. Labor _____ at _____ \$ _____
 Hrs. Compressor at _____ \$ _____
 _____ \$ _____
 _____ \$ _____
 Trucking _____ \$ _____
 Pav't Patch _____ \$ _____
 _____ \$ _____
 _____ \$ _____
 _____ \$ _____
 _____ \$ _____

FULTON

St. _____
 Assoc. No. 17

Name of Owner _____

Labor and Mat'l. Report 19 35, JUNE 7

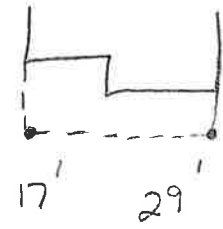

● Curb Box

10" Main

Elev. of Main at tap $4\frac{1}{2}'$

Gate at ● ● Gate at

● Curb Box

OLD TAP DISCONNECTED