

LABOR AND MATERIALS

1	Copper } Connection	3/4"	\$
1	Curb } Cock	3/4" in.	\$
1	Service box	{ Short 3-1/2 x 4-1/2	\$
	Old returned	{ long 4-1/2 x 5-1/2	\$
9	Ft. 3/4" in. { Copper		\$
		{ Gal.	
		{ Gal.	
	Nipples	in. at	\$
1	Bushings	3/4 to 1/2 in. at	\$
	Red'g		\$
	Inc'g		\$
	Union	in. at	\$
	Meter	in. at	\$
			\$
	Compound Joints at		\$
	Maintenance Foreman		\$
	Hrs. Water Maint. Man - 1 at		\$
	Hrs. Water Maint. Man - 2 at		\$
	Hrs. Garage Foreman	at	\$
	Hrs. Labor	at	\$
	Hrs. Compressor at		\$
			\$
	Trucking		\$
	Pav't Patch		\$
			\$
			\$
			\$
			\$

FULTON


St.

No.

22

Name of Owner

Labor and Mat'l. Report 19 29, AUG 2

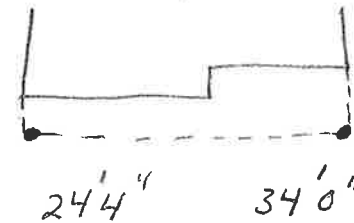

● Curb Box

10" Main

Elev. of Main at tap 6'

Gate at ●

● Gate at

● Curb Box

OLD TAP SHUT OFF