

LABOR AND MATERIALS

1 Copper	Connection	$\frac{3}{4}$	-----	\$ 1.23
1 Lead				
1 Curb	Cock Valve T.S. & V.	$\frac{3}{4}$	in.	\$ 1.68
1 Service Box	Old returned	Short $3\frac{1}{2} \times 4\frac{1}{2}$	}	\$ 1.54
		Long $4\frac{1}{2} \times 5\frac{1}{2}$		
		Buff. or Rdway		
23 Ft.		$\frac{3}{4}$	in.	
		Copper Galv. Iron Cast Iron	Pipe at 7	\$ 3.91
	Nipples	in.	at	\$
	Bushings	to	in. at	\$
	Red'g Inc'g	Couplings	to in. at	\$
	Union	in.	at	\$
	Meter	in.	at	\$
	Lead Joints			\$
	Leadite Joints			\$
	Hrs. Foreman			\$
2	Hrs. Chauffeur	$6\frac{1}{2}$		\$ 1.25
1	Hrs. Tapper	^		\$ 4.38
8	Hrs. Labor	45		\$ 3.60
	Hrs. Labor			\$
	Hrs. Compressor			\$
	Compensation Ins.			\$ 2.8
	Trucking			\$ 1.00
	Builders Use of Water	Patch		\$ 5.-
	<i>Tophy Hessel</i>			\$
				\$
				\$
				\$ 23.87


87 -- 1939

St.
Pl.
Ave. No. 25

Fulton

Name of Owner
David Brown

Labor and Mat'l. Report *Oct 30 1939*

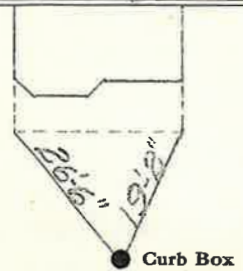

10 Main Elev. of Main at tap $\frac{5}{8}$ "

Gate at ● ● Gate at

TAX ID # 302.20-10-7

● Curb Box

old shut off