

### LABOR AND MATERIALS

1	Copper Lead	Connection	3/4		\$ 2.87
1	Curb	Cock Valve	3/4 in.		\$ 3.62
1	Service box	Short 3 1/2 X 4 1/2 Long <del>4 1/2 X 6 1/2</del> Buff or Rdway			
	Old returned				\$ 4.68
29	Ft.	Copper	3/4 in.	Pipe at 37	\$ 7.68
	Nipples		in.	at	\$
	Bushings		to	in. at	\$
	Red'g				\$
	Inc'g	Coupl'gs	to	in. at	\$
	Union		in.	at	\$
	Meter		in.	at	\$
	Lead Joints			at	\$
	Compound Joints			at	\$
5	Hrs.	Water Maint. Man-1	at 1.17		\$ 5.60
1	Hrs.	Water Maint. Man-2	at 1.07		\$ 7.14
15	Hrs.	Labor	at 91		\$ 13.65
	Hrs.	Labor	at		\$
	Hrs.	Compressor	at		\$
	Compensation Ins.	at \$ 2.9	per C.		\$ 0.54
	Trucking				\$ 2.00
	Pav't Patch				\$
	<i>Tap by Mazzini</i>				\$
	O'head				\$
					\$ 47.82

74

FULTON

St.

~~Pl.~~


Ave. No. 29

Name of Owner

*DAVIS*

Labor and Mat'l. Report

*June 23 19 49*

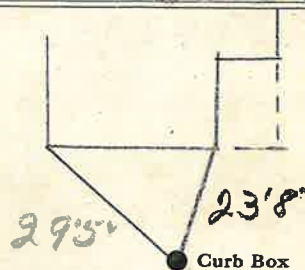

10" Main

Elev. of Main at tap

5'

Gate at ●

● Gate at

● Curb Box

Billed

LSM-5C 5 15-48

*National Bank Trust Co.*