

# LABOR AND MATERIALS


1	Copper } Connection	3/4	\$	
1	Lead } Cock Valve	3/4 in.	\$	
1	Curb } T.S. & V.		\$	
1	Service box	{ Short 3-1/2 x 4-1/2 }	\$	
	Old returned	{ Long 4-1/2 x 5-1/2 }	\$	
219	" Ft. 3/4 in. { Copper }		\$	
		Pipe at	\$	
	Nipples	in. at	\$	
	Bushings	to in. at	\$	
	Red'g		\$	
	Inc'g		\$	
	Union	in. at	\$	
	Meter	in. at	\$	
			\$	
	Compound Joints at		\$	
	Maintenance Foreman		\$	
	Hrs. Water Maint. Man - 1 at		\$	
	Hrs. Water Maint. Man - 2 at		\$	
	Hrs. Garage Foreman	at	\$	
	Hrs. Labor	at	\$	
	Hrs. Compressor at		\$	
			\$	
	Trucking		\$	
	Pav't Patch		\$	
			\$	
			\$	
FULTON

St. Ave. No. 33

Name of Owner  
TAX ID # 302.20-11-13

Labor and Mat'l. Report 19 33, AUG. 16

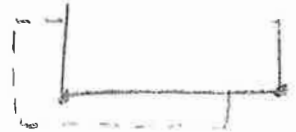

27-8 40-7

● Curb Box

10" Main

Elev. of Main at tap 52'

Gate at ●

● Gate at

● Curb Box

OLD SHUT OFF