

### LABOR AND MATERIALS

1	Lead	Copper Connection	3/4		\$ 2.87
1	Curb	Cock Valve	3/4 in.		\$ 3.62
		P. S. & V.			
	Service box	Short 3/4 X 4 1/2			
	Old returned	Long 4 1/2 X 5 1/2		Same	
		Buff or Rdway			
2.6	Ft.	Copper	3/4 in.	Pipe at 32	\$ 8.32
		C.I.			
		C.I.			
	Nipples	in. at			\$
	Bushings	to in. at			\$
	Red'g				
	Inc'g	Coupl'gs to in. at			\$
	Union	in. at			\$
	Meter	in. at			\$
	Lead Joints	at			\$
	Compound Joints	at			\$
5	Hrs.	Water Maint. Man-1	at 1.17		\$ 5.60
7	Hrs.	Water Maint. Man-2	at 1.02		\$ 7.14
15	Hrs.	Labor-	at 91		\$ 13.65
	Hrs.	Labor-	at		\$
	Hrs.	Compressor at			\$
	Compensation Ins.	at \$ 2.15 per C.			\$ 0.51
	Trucking				\$ 2.00
	Pav't Patch				\$
	<i>Tap by Warsaw</i>				\$
	.....				\$
	.....				\$
	.....				\$
	.....				\$
	O'head				\$
					\$ 43.58

66

St.  
Pl  
Ave. No. 5


Fulton

Name of Owner

Carlin

Labor and Mat'l. Report

June 25 1949

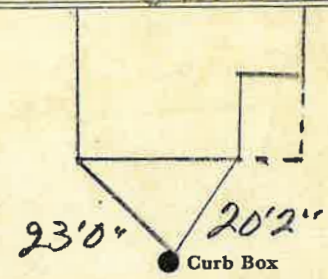

10

Elev. of  
Main at tap 5

Gate at ● Gate at ●

TAX ID # 302.20-9-11

● Curb Box

Tap. Be Billed

