

LABOR AND MATERIALS


1. Copper	Connection	3/4	\$ 2.87
1. Lead			
1. Curb	Cock Valve	3/4 in.	\$ 3.62
	T. S. & V.		
1. Service box	Short 3 1/2 X 4 1/2		
Old returned	Long 4 1/2 X 5 1/2		\$ 4.68
	Buff or Rdway		
13 Ft.	Copper	Pipe at 3/2	\$ 4.16
	G. I.		
	G. I.		
	Nipples	in. at	\$
	Bushings	to in. at	\$
	Red'g / Inc'g	Coupl'gs to in. at	\$
	Union	in. at	\$
	Meter	in. at	\$
	Lead Joints	at	\$
	Compound Joints	at	\$
4	Hrs. Water Maint. Man-1	at 1.12	\$ 4.48
3	Hrs. Water Maint. Man-2	at 1.02	\$ 3.06
7	Hrs. Labor	at 96	\$ 6.72
	Hrs. Labor	at	\$
	Hrs. Compressor	at	\$
	Compensation Ins.	at \$ 2.18 per C.	\$ 0.30
	Trucking		\$ 2.00
	Pav't Patch		\$
	Top 4.00		\$
	O'head		\$
			\$ 31.54

67

St. Fulton  
Pl. Ave. No. 6

Name of Owner  
Kiley

Labor and Mat'l. Report June 29 1910

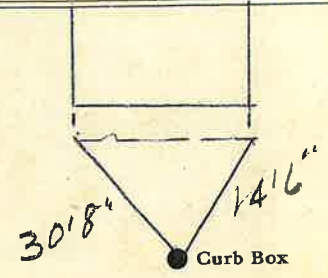

10 Main Elev. of Main at tap 5'

Gate at ● Gate at ●

● Curb Box

LSM-3C B 15-48 To be Billed ✓