

GAGE

St.

Pl.


Ave. No.

31

Name of Owner

FRED WEST

Labor and Mat'l. Report 19 37, MAY 7

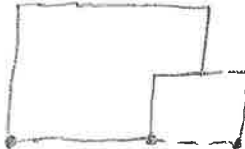

39 1/2" 27' 26 1/8"

● Curb Box

4" Main

Elev. of Main at tap

6'

Gate at ●

● Gate at

● Curb Box

OLD SHUT OFF

### LABOR AND MATERIALS

1	Copper } Connection $\frac{3}{4}$	\$
1	Lead } Cock Valve } $\frac{3}{4}$ in.	\$
1	Curb } T.S. & V. }	\$
1	Service box { Short 3-1/2 x 4-1/2 } Old returned { Long 4-1/2 x 5-1/2 }	\$
10	Ft. $\frac{3}{4}$ in. { Copper } Pipe at	\$
	{ Gal. }	
	Nipples _____ in. at _____	\$
	Bushings _____ to _____ in. at _____	\$
	Red'g _____	
	Inc'g _____	
	Union _____ in. at _____	\$
	Meter _____ in. at _____	\$
	Compound Joints at _____	\$
	Maintenance Foreman _____	\$
	Hrs. Water Maint. Man - 1 at _____	\$
	Hrs. Water Maint. Man - 2 at _____	\$
	Hrs. Garage Foreman _____ at _____	\$
	Hrs. Labor _____ at _____	\$
	Hrs. Compressor at _____	\$
	Trucking _____	\$
	Pav't Patch _____	\$
	_____	\$
	_____	\$
