

# LABOR AND MATERIALS


1	Copper } Connection $\frac{3}{4}$	\$	
1	Lead } Cock		
1	Curb } Valve } $\frac{3}{4}$ in.	\$	
	T.S. & V. }		
1	Service box { Short 3-1/2 x 4-1/2 }	\$	
	Old returned { Long 4-1/2 x 5-1/2 }		
10	Ft. $\frac{3}{4}$ in. { Copper } Pipe at	\$	
	Nipples _____ in. at	\$	
	Bushings _____ to _____ in. at	\$	
	Red'g		
	Inc'g		
	Union _____ in. at	\$	
	Meter _____ in. at	\$	
		\$	
	Compound Joints at	\$	
	Maintenance Foreman	\$	
	Hrs. Water Maint. Man - 1 at	\$	
	Hrs. Water Maint. Man - 2 at	\$	
	Hrs. Garage Foreman _____ at	\$	
	Hrs. Labor _____ at	\$	
	Hrs. Compressor at	\$	
		\$	
	Trucking	\$	
	Pav't Patch	\$	
		\$	
		\$	
GAGE

Ave. No. 37

Name of Owner  
STEPHAN LOCKHART

Labor and Mat'l. Report 1937, MAYS

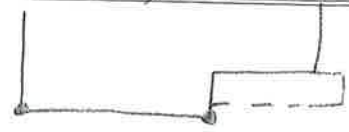

24'0" 29'4"

● Curb Box

4" Main

Elev. of Main at tap 6'

Gate at ● Gate at

● Curb Box

OLD SHUT OFF