

LABOR AND MATERIALS


1 Copper } Connection 3/4 \$ _____
 Lead }
 1 Curb } Cock } 3/4 in. \$ _____
 Valve } T.S. & V. }
 1 Service box { Short 3-1/2 x 4-1/2 } \$ _____
 Old returned { Long 4-1/2 x 5-1/2 }
 14 Ft. 3/4 in. { Copper } Pipe at \$ _____
 Nipples _____ in. at \$ _____
 Bushings _____ to _____ in. at \$ _____
 Red'g _____
 Inc'g _____
 Union _____ in. at \$ _____
 Meter _____ in. at \$ _____
 Compound Joints at \$ _____
 Maintenance Foreman \$ _____
 Hrs. Water Maint. Man - 1 at \$ _____
 Hrs. Water Maint. Man - 2 at \$ _____
 Hrs. Garage Foreman _____ at \$ _____
 Hrs. Labor _____ at \$ _____
 Hrs. Compressor at \$ _____
 Trucking \$ _____
 Pav't Patch \$ _____
 \$ _____
 \$ _____
GAGE

Ave. No. 39

Name of Owner
STEPHAN LOCKHART

Labor and Mat'l. Report 1937, MAY 6

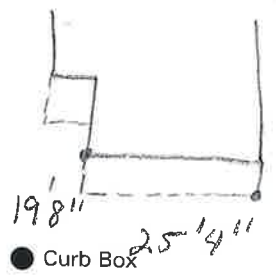

4" Main

Elev. of Main at tap 6'

Gate at ● Gate at ●

● Curb Box

OLD SHUT OFF