


LABOR AND MATERIALS

1 Copper } Connection 3/4 \$ _____
 Lead }
 1 Curb } Cock } 3/4 in. \$ _____
 Valve }
 F.C. & V. }
 1 Service box { Short 3-1/2 x 4-1/2 } \$ _____
 Old returned { Long 4-1/2 x 5-1/2 }
 24 Ft. 3/4 in. { Copper } Pipe at \$ _____
 Nipples _____ in. at \$ _____
 1 Bushings 3/4 to 5 in. at \$ _____
 1 ~~Rods~~ 3/4
 Inc'g _____
 Union _____ in. at \$ _____
 Meter _____ in. at \$ _____
 _____ \$ _____
 Compound Joints at \$ _____
 Maintenance Foreman \$ _____
 Hrs. Water Maint. Man - 1 at \$ _____
 Hrs. Water Maint. Man - 2 at \$ _____
 Hrs. Garage Foreman _____ at \$ _____
 Hrs. Labor _____ at \$ _____
 Hrs. Compressor at \$ _____
 _____ \$ _____
 Trucking \$ _____
 Pav't Patch \$ _____
 _____ \$ _____
 _____ \$ _____
 _____ \$ _____
 _____ \$ _____

GAGE Ave. No. 16A-B
 Name of Owner _____

Labor and Mat'l. Report 1928, JULY 31

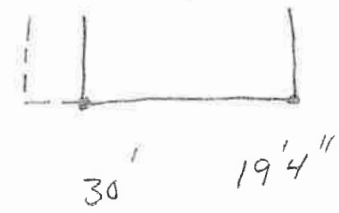

● Curb Box
6" Main Elev. of Main at tap 5'
 Gate at ● Gate at ●

TAX ID # 302.16-11-1

● Curb Box
 OLD TAP SHUT OFF