

LABOR AND MATERIALS

| | | | | |
|----|--------------------------------|-----------------------|----|--|
| 1 | Copper } Connection | $\frac{3}{4}$ | \$ | |
| 1 | Curb } Cock | $\frac{3}{4}$ in. | \$ | |
| | Valve | | | |
| 1 | Service box | { Short 3-1/2 x 4-1/2 | \$ | |
| | Old returned | { Long 4-1/2 x 5-1/2 | \$ | |
| 12 | Ft. $\frac{3}{4}$ in. { Copper | } Pipe at | \$ | |
| | | | | |
| | Nipples | in. at | \$ | |
| | Bushings | to in. at | \$ | |
| | Red'g | | | |
| | Inc'g | | | |
| | Union | in. at | \$ | |
| | Meter | in. at | \$ | |
| | | | \$ | |
| | Compound Joints at | | \$ | |
| | Maintenance Foreman | | \$ | |
| | Hrs. Water Maint. Man - 1 at | | \$ | |
| | Hrs. Water Maint. Man - 2 at | | \$ | |
| | Hrs. Garage Foreman | at | \$ | |
| | Hrs. Labor | at | \$ | |
| | Hrs. Compressor at | | \$ | |
| | | | \$ | |
| | Trucking | | \$ | |
| | Pav't Patch | | \$ | |
| | | | \$ | |
| | | | \$ | |

GAGE

Ave. No. 21

Name of Owner

GEO. AIKENS

Labor and Mat'l. Report 1937, MAY 7

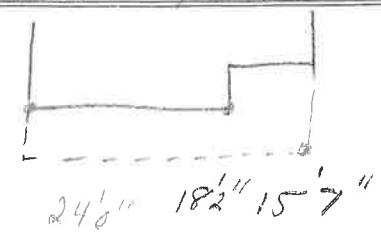

● Curb Box

4" Main

Elev. of Main at tap 5 1/2'

Gate at ●

● Gate at

● Curb Box

OLD SHUT OFF