


LABOR AND MATERIALS

1 Copper } Connection $\frac{3}{4}$ \$ _____
 Lead }
 1 Curb } Cock } $\frac{3}{4}$ in. \$ _____
 Valve }
 T.S. & V. }
 1 Service box { Short 3-1/2 x 4-1/2 } \$ _____
 Old returned { Long 4-1/2 x 5-1/2 }
 20 Ft. $\frac{3}{4}$ in. { Copper } Pipe at \$ _____
 Nipples _____ in. at \$ _____
 Bushings _____ to _____ in. at \$ _____
 Red'g _____
 Inc'g _____
 Union _____ in. at \$ _____
 Meter _____ in. at \$ _____
 _____ \$ _____
 Compound Joints at \$ _____
 Maintenance Foreman \$ _____
 Hrs. Water Maint. Man - 1 at \$ _____
 Hrs. Water Maint. Man - 2 at \$ _____
 Hrs. Garage Foreman _____ at \$ _____
 Hrs. Labor _____ at \$ _____
 Hrs. Compressor at \$ _____
 _____ \$ _____
 Trucking \$ _____
 Pav't Patch \$ _____
 _____ \$ _____
 _____ \$ _____
 _____ \$ _____
 _____ \$ _____

St. _____
 GARFIELD _____ No. 2

Name of Owner _____

Labor and Mat'l. Report 19 27, NOV 22

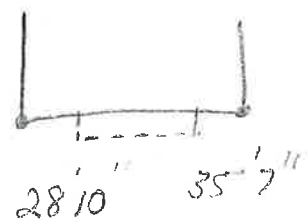

● Curb Box

6" Main Elev. of Main at tap 5'

Gate at ● Gate at

● Curb Box

NEW HOUSE
 NEW TAP