


# LABOR AND MATERIALS

1	Copper } Connection $\frac{3}{4}$	\$	
1	Curb } Cock Valve } $\frac{3}{4}$ in.	\$	
1	Service box { Short 3-1/2 x 4-1/2 } Old returned { Long 4-1/2 x 5-1/2 }	\$	
24	Ft. $\frac{3}{4}$ in. { Copper } Pipe at	\$	
	Nipples _____ in. at	\$	
	Bushings _____ to _____ in. at	\$	
	Red'g		
	Inc'g		
	Union _____ in. at	\$	
	Meter _____ in. at	\$	
	Compound Joints at	\$	
	Maintenance Foreman	\$	
	Hrs. Water Maint. Man - 1 at	\$	
	Hrs. Water Maint. Man - 2 at	\$	
	Hrs. Garage Foreman _____ at	\$	
	Hrs. Labor _____ at	\$	
	Hrs. Compressor at	\$	
	Trucking	\$	
	Pav't Patch	\$	
		\$	
		\$	
St. GARFIELD Ave. No. 16

Name of Owner \_\_\_\_\_

Labor and Mat'l. Report 19 31, MAR. 31

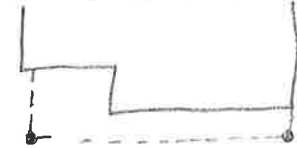

30'6" 21'8"

● Curb Box

6" Main

Elev. of Main at tap 52'

Gate at ●

● Gate at

● Curb Box

OLD TAP DISCONNECTED

# LABOR AND MATERIALS


Copper } Connection \_\_\_\_\_ \$  
 Lead }  
 Curb } Cock Valve } \_\_\_\_\_ in. \$  
 T.S. & V. }  
 Service box { Short 3-1/2 x 4-1/2 } \_\_\_\_\_ \$  
 Old returned { Long 4-1/2 x 5-1/2 }  
 Ft. \_\_\_\_\_ in. { Copper } Pipe at \_\_\_\_\_ \$  
 G.I.  
 C.I.  
 Nipples \_\_\_\_\_ in. at \_\_\_\_\_ \$  
 Bushings \_\_\_\_\_ to \_\_\_\_\_ in. at \_\_\_\_\_ \$  
 Red'g \_\_\_\_\_  
 Inc'g \_\_\_\_\_  
 Union \_\_\_\_\_ in. at \_\_\_\_\_ \$  
 Meter \_\_\_\_\_ in. at \_\_\_\_\_ \$  
 \_\_\_\_\_ \$  
 Compound Joints at \_\_\_\_\_ \$  
 Maintenance Foreman \_\_\_\_\_ \$  
 Hrs. Water Maint. Man - 1 at \_\_\_\_\_ \$  
 Hrs. Water Maint. Man - 2 at \_\_\_\_\_ \$  
 Hrs. Garage Foreman \_\_\_\_\_ at \_\_\_\_\_ \$  
 Hrs. Labor \_\_\_\_\_ at \_\_\_\_\_ \$  
 Hrs. Compressor at \_\_\_\_\_ \$  
 \_\_\_\_\_ \$  
 Trucking \_\_\_\_\_ \$  
 Pav't Patch \_\_\_\_\_ \$  
 \_\_\_\_\_ \$  
 \_\_\_\_\_ \$  
*Garfield*

St. \_\_\_\_\_  
 Pl. \_\_\_\_\_  
 Ave. No. 16

Name of Owner \_\_\_\_\_

Labor and Mat'l. Report 19 4-23-2014

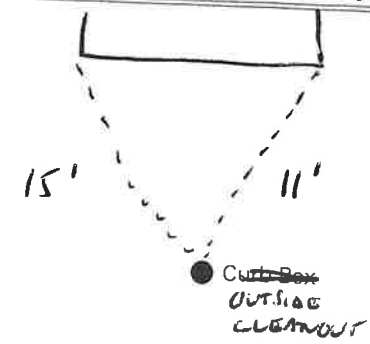

\_\_\_\_\_ Main  
 Elev. of Main at tap \_\_\_\_\_  
 Gate at ● \_\_\_\_\_ ● Gate at \_\_\_\_\_  
 \_\_\_\_\_  
 ● Curb Box