

LABOR AND MATERIALS

Copper } Connection.....	\$
Lead }	\$
Curb } Cock }	\$
Valve } T. S. & V. }	\$
Service Box } Short 3 1/2 x 4 1/2 }	\$
Old returned } Long 4 1/2 x 5 1/4 }	\$
} Buffer Rdway }	\$
22 Ft. 3/4 in. } Copper } Pipe at.....	\$
} Galv Iron }	
} Cast Iron }	
..... Nipples..... in. at	\$
..... Bushings..... to..... in. at	\$
Red'g } Couplings..... to..... in. at.....	\$
Inc'g }	
..... Union..... in. at	\$
..... Meter..... in. at	\$
..... Lead Joints at	\$
..... Leadite Joints at	\$
..... Hrs. Foreman at	\$
..... Hrs. Chauffeur at	\$
..... Hrs. Tapper at	\$
..... Hrs. Labor at	\$
..... Hrs. Labor at	\$
..... Hrs. Compressor at	\$
..... Compensation Ins.	\$
..... Trucking	\$
..... Builders Use of Water	\$
.....	\$
.....	\$
TAP MADE 1931


St. _____
 Pt. _____
 Ave. No. 202

Garfield

Name of Owner

Vacant Lot

Labor and Mat'l. Report **AUG 24 1939** 19

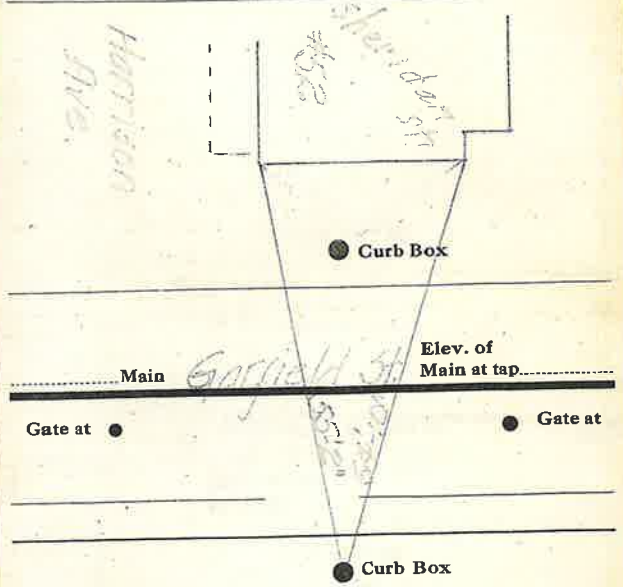

Vacant Lot