

LABOR AND MATERIALS

1	Copper	} Connection	3/4"	\$	
	Lead				
1	Curb	} Cock Valve T.S. & V.	3/4" in.	\$	
1	Same				
	Service box				
	Old returned	} Short 3 1/2 x 4 1/2 Long 4 1/2 x 5 1/2 Buff or Rdway		\$	
10	Ft. 3/4 in.		} Copper G.I. C.I.	} Pipe at	\$
	Nipples	in. at			\$
	Bushings	to	in. at	\$	
	Red'g	} Coupl'gs	to	in. at	
	Inc'g				
1	Union	3/4 in.	at	\$	
	Meter	in.	at	\$	
	Lead Joints	at		\$	
	Compound Joints	at		\$	
	Maintenance Foreman			\$	
	Hrs. Water Maint. Man-1	at		\$	
	Hrs. Water Maint. Man-2	at		\$	
	Hrs. Garage Foreman	at		\$	
	Hrs. Labor	at		\$	
	Hrs. Compressor	at		\$	
	Compensation Ins. at \$		per C	\$	
	Trucking			\$	
	Pav't Patch			\$	
	Tap by Gifford & Co			\$	
	5-2-68			\$	
	O'head			\$	

Garfield


St. ~~Pt.~~
Ave. No. 3

Name of Owner

Wilcox

Labor and Mat'l. Report

May 2 1968

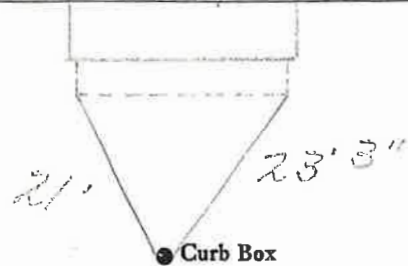

● Curb Box

6" Main

Elev. of Main at tap 5"

Gate at ●

● Gate at

TAX ID # 302.19-22-15

● Curb Box