


LABOR AND MATERIALS

- 1 Copper } Connection $\frac{3}{4}$ \$ _____
- 1 Lead } _____ \$ _____
- 1 Curb } Cock } $\frac{3}{4}$ in. \$ _____
- 1 Valve } T.S. & V. } _____ \$ _____
- 1 Service box { Short 3-1/2 x 4-1/2 } \$ _____
- Old returned { Long 4-1/2 x 5-1/2 } \$ _____
- 10 Ft. $\frac{3}{4}$ in. { Copper } Pipe at \$ _____
- _____ Nipples _____ in. at \$ _____
- _____ Bushings _____ to _____ in. at \$ _____
- _____ Red'g _____
- _____ Inc'g _____
- _____ Union _____ in. at \$ _____
- _____ Meter _____ in. at \$ _____
- _____ \$ _____
- _____ Compound Joints at \$ _____
- _____ Maintenance Foreman \$ _____
- _____ Hrs. Water Maint. Man - 1 at \$ _____
- _____ Hrs. Water Maint. Man - 2 at \$ _____
- _____ Hrs. Garage Foreman _____ at \$ _____
- _____ Hrs. Labor _____ at \$ _____
- _____ Hrs. Compressor at \$ _____
- _____ \$ _____
- _____ Trucking \$ _____
- _____ Pav't Patch \$ _____
- _____ \$ _____
- _____ \$ _____
St. GARFIELD
 Ave. No. 31
 Name of Owner _____

Labor and Mat'l. Report 19 31, MAY 7

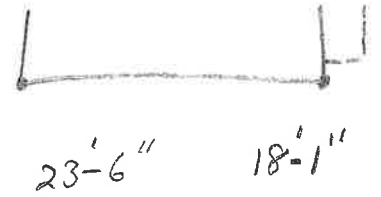

● Curb Box

6" Main Elev. of Main at tap 5'

Gate at ● Gate at ●

● Curb Box