

# LABOR AND MATERIALS


1	Copper } Connection		\$
1	Curb } Cock		\$
1	Curb } Valve		\$
1	Curb } T.S. & V.		\$
1	Service box	{ Short 3-1/2 x 4-1/2	\$
1	Old returned	{ Long 4-1/2 x 5-1/2	\$
10	Ft. 3/4 in. { Copper	} Pipe at	\$
		{ G.I. } { Sst. }	
	Nipples	in. at	\$
1	Bushings	3/4 to 1/2 in. at	\$
	Red'g		\$
	Inc'g		\$
	Union	in. at	\$
	Meter	in. at	\$
	Compound Joints at		\$
	Maintenance Foreman		\$
	Hrs. Water Maint. Man - 1 at		\$
	Hrs. Water Maint. Man - 2 at		\$
	Hrs. Garage Foreman	at	\$
	Hrs. Labor	at	\$
	Hrs. Compressor at		\$
	Trucking		\$
	Pav't Patch		\$
			\$
			\$
GARFIELD

St.   
 Ave. No. 35

Name of Owner

Labor and Mat'l. Report 1931, APR. 25

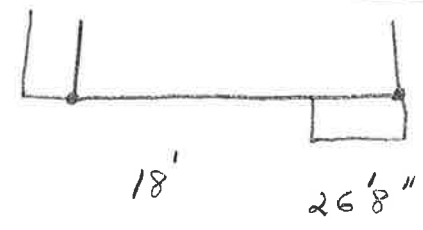

● Curb Box

6" Main

Elev. of Main at tap 5'

Gate at ●

● Gate at

● Curb Box

OLD TAP DISCONNECTED