


LABOR AND MATERIALS

Copper } Connection 3 \$ _____
 Lead } 4 \$ _____
 1 Curb } Cock Valve } _____ in. \$ _____
 1 T.C. & V. } } _____
 Service box { Short 3-1/2 x 4-1/2 } \$ _____
 Old returned { Long 4-1/2 x 6-1/2 } } _____
 8 Ft. 3/4 in. { Copper } Pipe at _____ \$ _____
 Nipples _____ in. at _____ \$ _____
 Bushings _____ to _____ in. at _____ \$ _____
 Red'g _____
 Inc'g _____
 Union _____ in. at _____ \$ _____
 Meter _____ in. at _____ \$ _____
 Compound Joints at _____ \$ _____
 Maintenance Foreman _____ \$ _____
 Hrs. Water Maint. Man - 1 at _____ \$ _____
 Hrs. Water Maint. Man - 2 at _____ \$ _____
 Hrs. Garage Foreman _____ at _____ \$ _____
 Hrs. Labor _____ at _____ \$ _____
 Hrs. Compressor at _____ \$ _____
 Trucking _____ \$ _____
 Pav't Patch _____ \$ _____
 _____ \$ _____
 _____ \$ _____
St. _____
 Ave. No. 36
GARFIELD
 Name of Owner _____

Labor and Mat'l. Report 19 35, OCT. 21

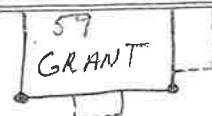

86' 65' 4"

● Curb Box

6" Main

Elev. of Main at tap 42'

Gate at ● ● Gate at

● Curb Box

LOT TAP

MEASURED FROM 59 GRANT