

# LABOR AND MATERIALS


<u>1</u>	Copper } Connection _____ \$ _____
<u>1</u>	Lead } Cock _____ \$ _____
	Curb } Valve _____ in. _____ \$ _____
	} T.S. & V. _____
<u>1</u>	Service box { Short 3-1/2 x 4-1/2 } _____ \$ _____
	Old returned { Long 4-1/2 x 5-1/2 } _____ \$ _____
<u>8</u>	Ft. _____ in. { Copper } Pipe at _____ \$ _____
	} Gal. _____
	} Gal. _____
	Nipples _____ in. at _____ \$ _____
	Bushings _____ to _____ in. at _____ \$ _____
	Red'g _____ \$ _____
	Inc'g _____ \$ _____
	Union _____ in. at _____ \$ _____
	Meter _____ in. at _____ \$ _____
	_____ \$ _____
	Compound Joints at _____ \$ _____
	Maintenance Foreman _____ \$ _____
	Hrs. Water Maint. Man - 1 at _____ \$ _____
	Hrs. Water Maint. Man - 2 at _____ \$ _____
	Hrs. Garage Foreman _____ at _____ \$ _____
	Hrs. Labor _____ at _____ \$ _____
	Hrs. Compressor at _____ \$ _____
	_____ \$ _____
	Trucking _____ \$ _____
	Pav't Patch _____ \$ _____
	_____ \$ _____
	_____ \$ _____
GARFIELD

St. 41  
 No. 41

Name of Owner \_\_\_\_\_

Labor and Mat'l. Report 1931, APR. 23

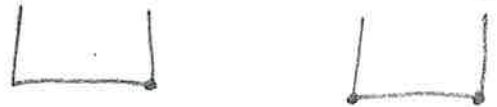

38-6"  
 or  
 54'  
 58-9" 676"  
 ● Curb Box

6" Main

Elev. of Main at tap 5'

Gate at ●

● Gate at

● Curb Box

LOT BACK OF S'S GRANT  
 AVE