


LABOR AND MATERIALS

1	Copper } Connection		\$
	Lead		
1	Curb } Cock		\$
	Valve } in.		
	to C. & V.		
1	Service box { Short 3-1/2 x 4-1/2		\$
	Old returned { Long 4-1/2 x 5-1/2		
25	Ft. 3/4 in. { Copper		\$
	to		
	Nipples	in. at	\$
	Bushings	to in. at	\$
	Red'g		
	Inc'g		
	Union	in. at	\$
	Meter	in. at	\$
			\$
	Compound Joints at		\$
	Maintenance Foreman		\$
	Hrs. Water Maint. Man - 1 at		\$
	Hrs. Water Maint. Man - 2 at		\$
	Hrs. Garage Foreman	at	\$
	Hrs. Labor	at	\$
	Hrs. Compressor at		\$
			\$
	Trucking		\$
	Pav't Patch		\$
			\$
			\$
			\$
			\$

St. GARFIELD
 No. 54
 Name of Owner _____

Labor and Mat'l. Report 19 27, DEC. 17

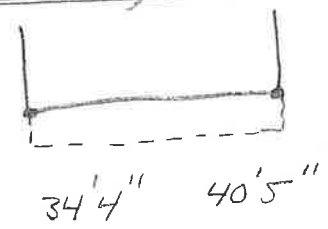

● Curb Box
 Main
 Elev. of Main at tap 4 1/2
 Gate at ● ● Gate at

● Curb Box
 NEW HOUSE
 NEW TAP