


Labor and Materials

1	Copper	Connection	1	\$3.50
1	Lead			
4	Curb	Cock Valve	1	\$3.06
1	Service Box	Short 3 1/2 x 4 1/2		
	Old returned	Long 4 1/2 x 5 1/2		\$1.44
		Butt or R.S. w.		
29	Ft.	Copper		
	1	Galv. Iron		\$6.67
	in	Cast Iron		
		Pipe at		
		Nipples		\$
		Bushings		\$
		Red'g		\$
		Inc'g		\$
		Couplings		\$
		Union		\$
		Meter		\$
		Lbs. Br. Stone		\$
		Lbs. Sand		\$
		Bags Cement		\$
		Paving Brick		\$
		Lead Joints		\$
		Leadite Joints		\$
4	Hrs.	Foreman	6 1/2	\$2.50
4	Hrs.	Common Labor	50	\$2-
9	Hrs.	Common Labor	45	\$4.05
		Hrs. Mason		\$
		Hrs. Masons Helper		\$
		Hrs. Compressor		\$
		Compensation Ins		\$0.31
		Trucking		\$1-
		Builders Use of Water	Paint Patch	\$5-
Total				\$29.53

47 34

Labor and Material Report July 12 1936

2 Gear St

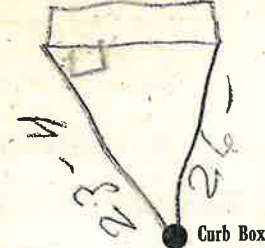

RAZED?

6 Main Elev. of Main at tap 4 1/2

Gate at • Gate at

• Curb Box

old tap shut off at main

[Handwritten initials]

[Handwritten initials]