

LABOR AND MATERIALS


1 Copper } Connection $3/4$ " (1/4 Elbow) \$
 Lead }
 1 Curb } Cock } $3/4$ " in. (MARK II) \$
 Valve }
 Ferrule }
 1 Service box { Short $3\frac{1}{2}$ x $4\frac{1}{2}$ }
 Old returned { Long $4\frac{1}{2}$ x $5\frac{1}{2}$ }
 Buff. or Rdway } \$
 15 $3/4$ in. { Copper } Pipe at \$
 C.I. }
 C.I. }
 Nipples in. at \$
 Bushings to in. at \$
 Red'g }
 Inc'g } Coupl'gs to in. at \$
 Union in. at \$
 Meter in. at \$
 Lead Joints at \$
 Compound Joints at \$
 Maintenance Foreman \$
 Hrs. Water Maint. Man-1 at \$
 Hrs. Water Maint. Man-2 at \$
 Hrs. Garage Foreman at \$
 Hrs. Labor at \$
 Hrs. Compressor at \$
 Compensation Ins. at \$ per C \$
 Trucking \$
 Pav't Patch \$
 TAP MADE BY GIFFORD & CO \$
 Aug-3-1973 \$
 O'head \$
 \$

G.C.R.

St. Ave. No. 3

Name of Owner
 MRS. Roberts Roberts

Labor and Mat'l. Report Aug 3 1973

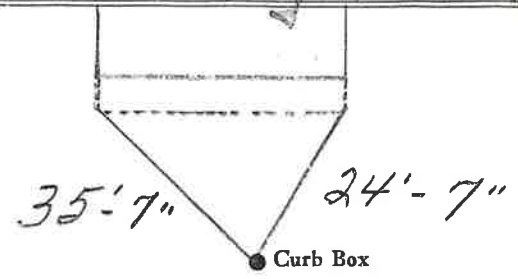

6" Main Elev. of Main at tap 5'
 Gate at • Gate at •

• Curb Box