

LABOR AND MATERIALS

1 Copper } Connection $\frac{3}{4}$	\$ 1.31
Lead }.....	
1 Curb { Cock } $\frac{3}{4}$ in.....	\$ 1.75
Valve } T.S. & V. }.....	
1 Service Box } Short $3\frac{1}{2} \times 4\frac{1}{2}$ }.....	\$ 1.60
Old returned } Long $4\frac{1}{2} \times 5\frac{1}{2}$ }.....	
} Buff for Rdway }.....	
25 Ft. $\frac{3}{4}$ in. { Copper } Pipe at 18 \$ 4.50	
} Galv Iron }.....	
} Cast Iron }.....	
..... Nipples..... in. at.....	\$
..... Bushings..... to..... in. at.....	\$
Red'g } Couplings..... to..... in. at.....	\$
Inc'g }.....	
..... Union..... in. at.....	\$
..... Meter..... in. at.....	\$
..... Lead Joints at.....	\$
..... Leadite Joints at.....	\$
..... Hrs. Foreman at.....	\$
3 Hrs. Chauffeur at 62h.....	\$ 1.87
1 Hrs. Tapper at.....	\$ 63
26 Hrs. Labor at 45.....	\$ 11.70
..... Hrs. Labor at.....	\$
..... Hrs. Compressor at.....	\$
..... Compensation Ins.....	\$ 44
..... Trucking.....	\$ 1
Builders Use of Water 545 of main.....	\$
Tape by Hessel.....	\$
.....	\$
.....	\$
.....	\$
.....	\$
\$ 24.80	


Geer

St. 12
 Pt. ~~11~~
 Ave. No. ~~11~~

Name of Owner

Olesky

Labor and Mat'l. Report Dec 18 1940

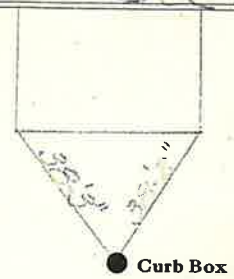

6" Main

Elev. of Main at tap 5'

Gate at ●

● Gate at

● Curb Box