

LABOR AND MATERIALS

1	Copper Lead	Connection	3/4			\$ 2.80
1	Curb	Clock Valve F.S. & V.	3/4	in.		\$ 3.60
1	Service box Old returned	Short 3 3/4 X 4 3/4 Long 4 1/2 X 5 3/4 Buff or Rdway				\$ 5.80
29	Ft.	3/4	in.	Copper Cast Iron Cast Iron	Pipe at	35 \$ 10.15
	Nipples		in.	at		\$
	Bushings		to	in.	at	\$
	Red'g Inc'g	Couplings	to	in.	at	\$
	Union		in.	at		\$
	Meter		in.	at		\$
	Lead Joints			at		\$
	Compound Joints			at		\$
	Hrs. Foreman			at		\$
1	Hrs. Chauffeur		91			\$ 91
2	Hrs. Tapper		91			\$ 1.82
12	Hrs. Labor		80			\$ 9.60
	Hrs. Labor			at		\$
	Hrs. Compressor			at		\$
	Compensation Ins.					\$ 27
	Trucking					\$ 1.00
	Builders Use of Water					\$
	<i>Tap by Malarsinski</i>					\$
						\$
						\$
						\$ 35.95


176-47

St.
Pl.
Ave. No. 14

Goe

Name of Owner
Olesky

Labor and Mat'l. Report Sept 28 1947

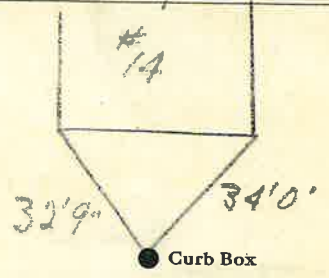

6 Main Elev. of Main at tap 5'

