


LABOR AND MATERIALS

Copper } Connection _____	\$ _____
Lead } _____	\$ _____
Curb } Cock _____	in. \$ _____
} Valve _____	
} T. S. & V. _____	
Service box } Short 3½ x 4½ } _____	\$ _____
Old returned } Long 4½ x 5½ } _____	\$ _____
Ft. <u>34</u> in. } Copper } Pipe at _____	\$ _____
} G.I. } _____	
} C.I. } _____	
Nipples _____ in. at _____	\$ _____
Bushings _____ to _____ in. at _____	\$ _____
Red'g } Coupl'gs _____ to _____ in. at _____	\$ _____
Inc'g } _____	
Union _____ in. at _____	\$ _____
Meter _____ in. at _____	\$ _____
_____	\$ _____
Compound Joints at _____	\$ _____
Maintenance Foreman _____	\$ _____
Hrs. Water Maint. Man-1 at _____	\$ _____
Hrs. Water Maint. Man-2 at _____	\$ _____
Hrs. Garage Foreman _____ at _____	\$ _____
Hrs. Labor _____ at _____	\$ _____
Hrs. Compressor at _____	\$ _____
_____	\$ _____
Trucking _____	\$ _____
Pav't Patch _____	\$ _____
_____	\$ _____
_____	\$ _____
_____	\$ _____
_____	\$ _____

Geer St. Pl.
Ave. No. _____

Name of Owner
D' Ambrosio Textile

Labor and Mat'l. Report 1986

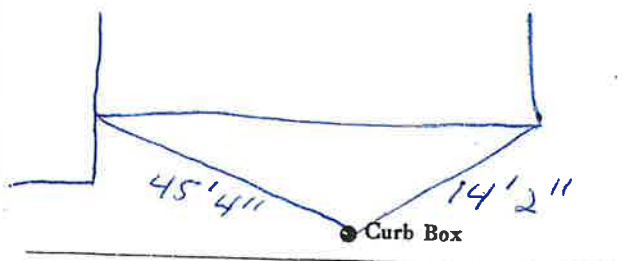

_____ Main Elev. of Main at tap _____
Gate at • Gate at •

• Curb Box