

LABOR AND MATERIALS

_____ Copper } Connection _____ \$ _____
 _____ Lead }
 _____ Curb } Cock } _____ in. \$ _____
 _____ } Valve }
 _____ } T.S. & V. }
 _____ Service box { Short 3-1/2 x 4-1/2 } _____ \$ _____
 _____ Old returned { Long 4-1/2 x 5-1/2 }
 36 Ft. 1" in. { Copper } Pipe at _____ \$ _____
 _____ Nipples _____ in. at _____ \$ _____
 _____ Bushings _____ to _____ in. at _____ \$ _____
 _____ Red'g _____
 _____ Inc'g _____
 _____ Union _____ in. at _____ \$ _____
 _____ Meter _____ in. at _____ \$ _____
 _____ \$ _____
 _____ Compound Joints at _____ \$ _____
 _____ Maintenance Foreman _____ \$ _____
 _____ Hrs. Water Maint. Man - 1 at _____ \$ _____
 _____ Hrs. Water Maint. Man - 2 at _____ \$ _____
 _____ Hrs. Garage Foreman _____ at _____ \$ _____
 _____ Hrs. Labor _____ at _____ \$ _____
 _____ Hrs. Compressor at _____ \$ _____
 _____ \$ _____
 _____ Trucking _____ \$ _____
 _____ Pav't Patch _____ \$ _____
 _____ \$ _____
 _____ \$ _____
St. _____
 _____ GEFR _____
 _____ No. 21

Name of Owner _____
AMES CHEMICAL - FRONTS
21 ROGERS

Labor and Mat'l. Report 1967, JULY 7



43' 2" 47' 5"

● Curb Box

6" Main

Elev. of Main at tap 4'

Gate at ●

● Gate at

● Curb Box


LABOR AND MATERIALS

1	Copper	{ Connection	3/4"	\$	3.04
1	Lead	{ Cock			
1	Curb	{ Valve	3/4 in.	\$	3.54
		{ T.S. & V.			
SAME	Service box	{ Short	3 1/2 x 4 1/2		
	Old returned	{ Long	4 1/2 x 5 1/2		
		{ Buff or Rdway		\$	
31	Ft. 3/4 in.	{ Copper	Pipe at 35	\$	10.85
		{ G.I.			
		{ C.I.			
	Nipples	in. at		\$	
	Bushings	to in. at		\$	
	Red'g	{ Coupl'gs	to in. at	\$	
	Inc'g				
	Union	in. at		\$	
	Meter	in. at		\$	
	Lead Joints	at		\$	
	Compound Joints	at		\$	
	Hrs. Water Maint. Man-1	at		\$	
9	Hrs. Water Maint. Man-2	at 1.13		\$	10.17
36	Hrs. Labor	at 1.02		\$	36.72
	Hrs. Labor	at		\$	
	Hrs. Compressor	at		\$	
	Compensation Ins. at \$ 2.666 per C.			\$	1.25
	Trucking			\$	1.00
	Pav't Patch	B Parking		\$	
				\$	
				\$	
	O'head			\$	
	Tap by Giggord			\$	66.59
	7-11-51				

St. Geer
 Ave. No. 39

Name of Owner
Ames Gold Smith

Labor and Mat'l. Report July 11 19 51

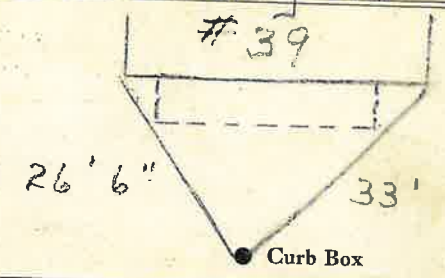


4" Main Elev. of Main at tap 3'
 Gate at ● Gate at ●

● Curb Box

39 GERR

Tap made 1906

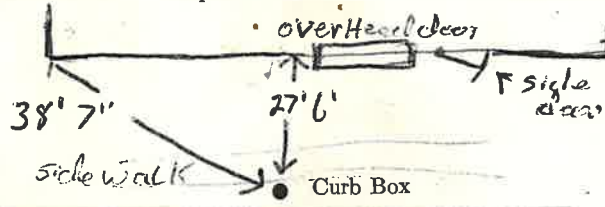

4 in. Main Elev. of Main at tap 3'

Gate at • Gate at

2/23/06

• Curb Box

Ames Gold Smith

39 Gear Street

Transferred to:
 City Map _____
 Street Profile _____
 Curb Box Record _____

(GIVEN TO PAYER)