

Ackley


St. Pl. Ave. No. 2

Name of Owner

Nick Barber

Labor and Mat'l. Report

July 19 1976

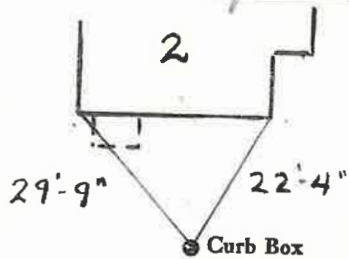

6" Main

Main

Elev. of Main at tap 5'

Gate at ●

● Gate at

TAX ID # 302.20-5-8.1

● Curb Box

LSM-5C-6-1-67

LABOR AND MATERIALS

1	Copper Lead	Connection	3/4"	\$
1	Curb	Cock Valve T.S. & V.	3/4 in. oriseal	\$
1	Service box Old returned	Short 3 1/2 x 4 1/2 Long 4 1/2 x 5 1/2 Buff or Rdway	4'x5'	\$
9 1/2	Ft. 3/4 in.	Copper Gal. Gal.	Pipe at	\$
	Nipples	in. at		\$
	Bushings	to in. at		\$
	Red'g Ino'g	Coupl'gs to in. at		\$
	Union	in. at		\$
	Meter	in. at		\$
	Lead Joints	at		\$
	Compound Joints	at		\$
	Maintenance Foreman			\$
	Hrs. Water Maint. Man-1	at		\$
	Hrs. Water Maint. Man-2	at		\$
	Hrs. Garage Foreman	at		\$
	Hrs. Labor	at		\$
	Hrs. Compressor	at		\$
	Compensation Ins.	at \$ per C		\$
	Trucking			\$
	Pav't Patch			\$
	TAP BY PURVIS + Co			\$
	July 19-1976			\$
	O'head			\$