


### LABOR AND MATERIALS

1	Copper Lead	} Connection	3/4"	11		\$
1	Curb	} Cock Valve T.S. & V.	3/4 in.		ORISEAL	\$
1	Service box Old returned	} Short 3 1/2 x 4 1/2 Long 4 1/2 x 5 1/2 Buff or Rdway				\$
28	Ft.	} Copper G.I.	3/4 in.		Pipe at	\$
	Nipples	in. at				\$
	Bushings	to in. at				\$
	Red'g Inc'g	} Coupl'gs	to	in. at		\$
	Union	in. at				\$
	Meter	in. at				\$
	Lead Joints	at				\$
	Compound Joints	at				\$
	Maintenance Foreman					\$
	Hrs. Water Maint. Man-1	at				\$
	Hrs. Water Maint. Man-2	at				\$
	Hrs. Garage Foreman	at				\$
	Hrs. Labor	at				\$
	Hrs. Compressor	at				\$
	Compensation Ins.	at \$			per C	\$
	Trucking					\$
	Pav't Patch					\$
	TAP BY GIFFORD & CO					\$
	6-24-64					\$
	O'head					\$
						\$

St.  
Pl. ARBOR DRIVE  
Ave. No. 2

Name of Owner  
DR OREL FREIDMAN

Labor and Mat'l. Report 19 let

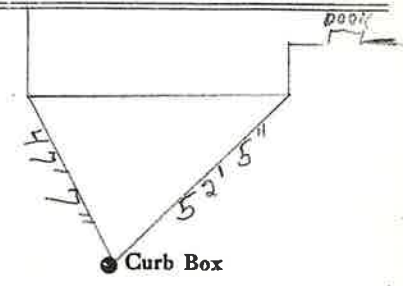

6" Main Elev. of Main at tap 5'

Gate at • • Gate at

ADDITION TO HOUSE  
#4 ARBOR DRIVE • Curb Box  
FOR OFFICE