

LABOR AND MATERIALS


1	Copper	Connection	3/4	\$
1	Curb	Cock	3/4 in.	\$
		Valve		
		T.S. & V.		
1	Service box	Short 3 1/2 x 4 1/2		\$
	Old returned	Long 4 1/2 x 5 1/2		\$
		Ball or Redway		\$
29	Ft.	3/4 in. Copper	Pipe at	\$
		GI		\$
	Nipples	in. at		\$
	Bushings	to in. at		\$
	Red'g			\$
	Inc'g	Coupl'gs to in. at		\$
	Union	in. at		\$
	Meter	in. at		\$
	Lead Joints	at		\$
	Compound Joints	at		\$
	Maintenance Foreman			\$
	Hrs. Water Maint. Man-1	at		\$
	Hrs. Water Maint. Man-2	at		\$
	Hrs. Garage Foreman	at		\$
	Hrs. Labor	at		\$
	Hrs. Compressor	at		\$
	Compensation Ins. at \$	per C		\$
	Trucking			\$
	Pav't Patch			\$
				\$
				\$
				\$
	O'head			\$
				\$

St. Pl. Ave. No. 20

ARBOR DRIVE

Name of Owner

Labor and Mat'l. Report MAY 14 1957

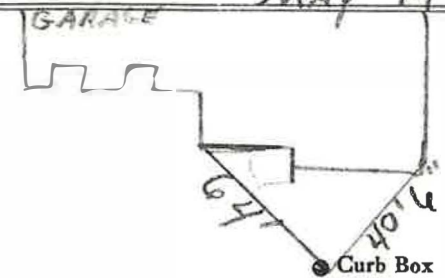

6" Main Elev. of Main at tap 6'

Gate at • Gate at

• Curb Box

TAX ID #302.11-6-26