


LABOR AND MATERIALS

1	Copper	} Connection	3/4	\$
	Lead			
1	Curb	} Cock Valve	3/4 in.	\$
	Service box	} Short 3 1/2 x 4 1/2		\$
	Old returned			
		Buff or Rdway		
11	Ft. 3/4 in.	} Copper		\$
			Pipe at	
	Nipples	in. at		\$
	Bushings	to in. at		\$
	Red'g	} Coupl'gs	to in. at	\$
	Inc'g			
	Union	in. at		\$
	Meter	in. at		\$
	Lead Joints	at		\$
	Compound Joints	at		\$
	Maintenance Foreman			\$
	Hrs. Water Maint. Man-1	at		\$
	Hrs. Water Maint. Man-2	at		\$
	Hrs. Garage Foreman	at		\$
	Hrs. Labor	at		\$
	Hrs. Compressor	at		\$
	Compensation Ins. at \$	per C		\$
	Trucking			\$
	Pav't Patch			\$
				\$
				\$
	O'head			\$
				\$

ARBOR DRIVE St. Pl. Ave. No. 21

Name of Owner

Labor and Mat'l. Report AUG. 14 1950

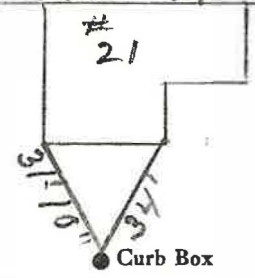

6" Main Elev. of Main at tap 6'

Gate at • Gate at •
11' to main

• Curb Box