


LABOR AND MATERIALS

1	Copper	} Connection	3/4"	\$
	Lead			
1	Curb	} Valve	3/4 in.	\$
	T.S. & V.			
1	Service box	} Short 3 1/2 x 4 1/2		\$
	Old returned			
9	Ft. 3/4 in.	} Copper		\$
	Nipples	in. at		\$
	Bushings	to in. at		\$
	Red'g	} Coupl'gs	to in. at	\$
	Inc'g			
	Union	in. at		\$
	Meter	in. at		\$
	Lead Joints	at		\$
	Compound Joints	at		\$
	Maintenance Foreman			\$
	Hrs. Water Maint. Man	—1 at		\$
	Hrs. Water Maint. Man	—2 at		\$
	Hrs. Garage Foreman	at		\$
	Hrs. Labor	at		\$
	Hrs. Compressor	at		\$
	Compensation Ins.	at \$ per C		\$
	Trucking			\$
	Pav't Patch			\$
	Tap by Giggord & Co.			\$
	11-30-60.			\$
	O'head			\$

St. Arbor Dr.
 Pl. Ave. No. 23
 Name of Owner Charles Chase

Labor and Mat'l. Report Nov. 30-1960

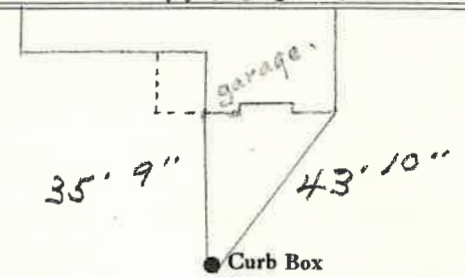

6" C.I. Main Elev. of Main at tap 5'

Gate at • Gate at

• Curb Box