

LABOR AND MATERIALS

1	Copper Lead	{ Connection	3/4"	\$	304
1	Curb	{ Cock Valve F.S. & V. }	3/4" in.	\$	354
1	Service box Old returned	{ Short 3 1/2 x 4 1/2 Long 4 1/2 x 5 1/2 Buff or Rdway }		\$	470
25	Ft. 3/4 in.	{ Copper C.I. C.L. }	Pipe at 35	\$	875
	Nipples	in. at		\$	
	Bushings	to in. at		\$	
	Red'g Inc'g	{ Coupl'gs to in. at }		\$	
	Union	in. at		\$	
	Meter	in. at		\$	
	Lead Joints	at		\$	
	Compound Joints	at		\$	
	Hrs. Water Maint. Man-1	at		\$	
	Hrs. Water Maint. Man-2	at		\$	
2	Hrs. Labor	A.M. at	1.26	\$	2.52
8	Hrs. Labor	at	1.02	\$	8.16
	Hrs. Compressor	at		\$	
	Compensation Ins. at	\$266 per C.		\$	28
	Trucking			\$	1.00
	Pav't Patch			\$	
	O'head			\$	
	Tap by Gifford			\$	31.99

5-7-51


\$901

72-1951

Arbor Drive St. Pt. Ave. No. 24

Name of Owner Lester N. Towne

Labor and Mat'l. Report 5-7 1951

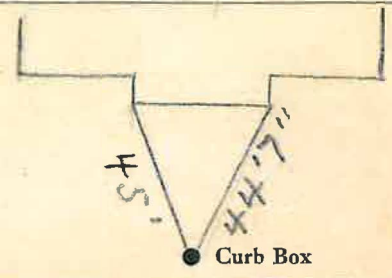

6" Main Elev. of Main at tap 5'

Gate at • Gate at •

• Curb Box