

LABOR AND MATERIALS

Copper } Connection _____	\$ _____
Lead } _____	
Curb } Cock Valve } _____ in.	\$ _____
	T. S. & V. }
Service box } Short 3½ x 4½ } _____	\$ _____
Old returned } Long 4½ x 5½ } _____	
	Buff or Rdway }
8'8" Ft. in. } Copper } Pipe at _____	\$ _____
	C.I. }
	C.I. }
Nipples _____ in. at _____	\$ _____
Bushings _____ to _____ in. at _____	\$ _____
Red'g } Coupl'gs _____ to _____ in. at _____	\$ _____
Inc'g }	
Union _____ in. at _____	\$ _____
Meter _____ in. at _____	\$ _____
Lead Joints at _____	\$ _____
Compound Joints at _____	\$ _____
Maintenance Foreman _____	\$ _____
Hrs. Water Maint. Man—1 at _____	\$ _____
Hrs. Water Maint. Man—2 at _____	\$ _____
Hrs. Garage Foreman _____ at _____	\$ _____
Hrs. Labor _____ at _____	\$ _____
Hrs. Compressor at _____	\$ _____
Compensation Ins. at \$ _____ per C	\$ _____
Trucking _____	\$ _____
Pav't Patch _____	\$ _____
_____	\$ _____
_____	\$ _____
_____	\$ _____
O'head _____	\$ _____
_____	\$ _____

Dr
St.
Pl.
Av.


Arbon

No. 31

Name of Owner _____

Labor and Mat'l. Report _____

19

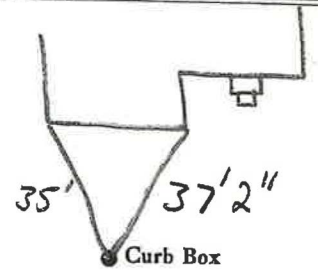

● Curb Box

Main _____

Elev. of Main at tap _____

Gate at ● _____

● Gate at _____

● Curb Box