

LABOR AND MATERIALS


/	Copper } Connection	3 1/2"		\$
	Lead }			
/	Curb } Cock Valve	3 1/4 in.		\$
	T.S. & V. }			
/	Service box } Short 3 1/2 x 4 1/2	}		
	Old returned } Long 4 1/2 x 5 1/2			
			Buff or Rdway	\$
25	Ft. } Copper	3/4 in.	Pipe at	\$
		G.I.		
		G.I.		
	Nipples	in. at		\$
	Bushings	to in. at		\$
	Red'g } Coupl'gs	to in. at		\$
	Inc'g }			
	Union	in. at		\$
	Meter	in. at		\$
	Lead Joints	at		\$
	Compound Joints	at		\$
	Maintenance Foreman			\$
	Hrs. Water Maint. Man-1	at		\$
	Hrs. Water Maint. Man-2	at		\$
	Hrs. Garage Foreman	at		\$
	Hrs. Labor	at		\$
	Hrs. Compressor	at		\$
	Compensation Ins. at \$	per C		\$
	Trucking			\$
	Pav't Patch			\$
	TAP BY MILLED 11-17-55			\$
				\$
				\$
	O'head			\$
				\$

St. _____
Pl. _____
Ave. No. 4

ARBOR DRIVE

Name of Owner _____
OREL FRIEDMAN

Labor and Mat'l. Report NOV. 17 19 55

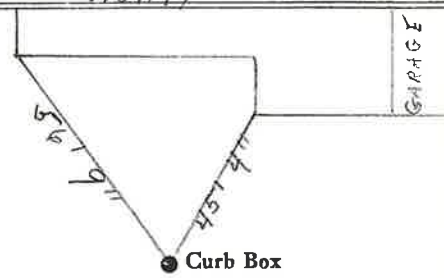

6" Main Elev. of Main at tap 5 1/2'

Gate at ● ● Gate at

FOR HOUSE
GARAGE ● Curb Box