


79-1556

St. Arbor Dr.
Pl. 37
Ave. No.

Name of Owner
William Chambers

Labor and Mat'l. Report May 21 1951

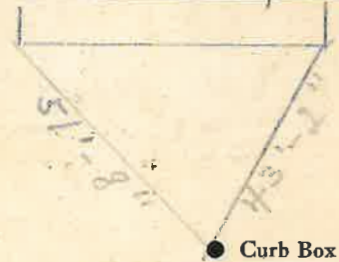

6" Main Elev. of Main at tap 5'

Gate at ● Gate at ●

● Curb Box

LSM-5C 10-21-49

LABOR AND MATERIALS

| | | | | |
|----|-------------------------|--|----|--------------|
| 1 | Copper Lead | { Connection <u>3/4"</u> | \$ | <u>3.04</u> |
| 1 | Curb | { Cock Valve T. S. & V. <u>3/4 in.</u> | \$ | <u>3.54</u> |
| 1 | Service box | { Short <u>3 1/2 x 4 1/2</u> | \$ | <u>4.70</u> |
| | Old returned | { Long <u>4 1/2 x 5 1/2</u> | | |
| 9 | Ft. <u>3/4 in.</u> | { Copper G. I. C. I. } Pipe at <u>35</u> | \$ | <u>3.15</u> |
| | Nipples | in. at | \$ | |
| | Bushings | to in. at | \$ | |
| | Red'g | { Coupl'gs to in. at | \$ | |
| | Inc'g | | \$ | |
| | Union | in. at | \$ | |
| | Meter | in. at | \$ | |
| | Lead Joints | at | \$ | |
| | Compound Joints | at | \$ | |
| | Hrs. Water Maint. Man-1 | at | \$ | |
| | Hrs. Water Maint. Man-2 | at | \$ | |
| 17 | Hrs. Labor | at <u>1.02</u> | \$ | <u>17.34</u> |
| | Hrs. Labor | at | \$ | |
| | Hrs. Compressor | at | \$ | |
| | Compensation Ins. | at \$ per C. | \$ | <u>46</u> |
| | Trucking | | \$ | <u>1.00</u> |
| | Pav't Patch | | \$ | |
| | O'head | | \$ | |
| | Tap by Gifford | | \$ | <u>33.23</u> |

5-21-51