

LABOR AND MATERIALS


1	Copper	{ Connection	3/4"	\$	2.29
	Lead				
1	Curb	{ Cock Valve T.S. & V. }	3/4" in.	\$	2.70
1	Service box	{ Short 3 1/2 x 4 1/2 }		\$	4.25
	Old returned	{ Long 4 1/2 x 5 1/2 }			
		{ Buff or Rdway }		\$	
2.7	Ft.	3/4 in.	Copper Pipe at	35	\$ 9.45
			C.I.		
	Nipples	in. at		\$	
	Bushings	to in. at		\$	
	Red'g	{ Coupl'gs to in. at		\$	
	Inc'g				
	Union	in. at		\$	
	Meter	in. at		\$	
	Lead Joints	at		\$	
	Compound Joints	at		\$	
	Hrs. Water Maint. Man-1	at		\$	3.86
2	Hrs. Water Maint. Man-2	at	1.02	\$	2.04
✓	Hrs. Labor	at	91	\$	1.82
	Hrs. Labor	at		\$	
	Hrs. Compressor	at		\$	
	Compensation Ins. at \$	per C.		\$	.09
	Trucking			\$	1.00
	Pav't Patch			\$	14.85
	Tap by Maguin			\$	
				\$	
				\$	
	O'head			\$	
				\$	38.49

130-1950

✓  
 Arbor Drive  
 St. Pl. Ave. No. 38

Name of Owner  
 Mason Jaynes  
 James?

Labor and Mat'l. Report  
 July 19 1950

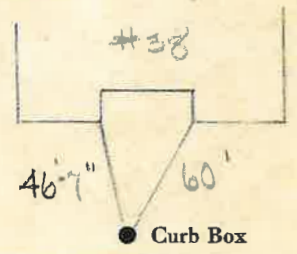

6" Main  
 Elev. of Main at tap 5 1/2'

Gate at ● Gate at ●

● Curb Box