

LABOR AND MATERIALS

Copper	} Connection	_____	\$ _____
Lead			
Curb	} Cock Valve T. S. & V. }	_____ in.	\$ _____
Service box		{ Short 3½ x 4½ Long 4½ x 5½ }	
Old returned			
Ft. <u>3/4</u> in.	{ Copper G. I. C. I. }	Pipe at _____	\$ _____
Nipples	in. at _____		\$ _____
Bushings	to _____ in. at _____		\$ _____
Red'g Inc'g	} Coupl'gs	to _____ in. at _____	\$ _____
Union		in. at _____	\$ _____
Meter	in. at _____		\$ _____
Compound Joints	at _____		\$ _____
Maintenance Foreman			\$ _____
Hrs. Water Maint. Man—1	at _____		\$ _____
Hrs. Water Maint. Man—2	at _____		\$ _____
Hrs. Garage Foreman	at _____		\$ _____
Hrs. Labor—	at _____		\$ _____
Hrs. Compressor	at _____		\$ _____
Trucking			\$ _____
Pav't Patch			\$ _____
			\$ _____
			\$ _____
			\$ _____
			\$ _____


ARBOR

DR
St.
Pt.
Ave. No. 40-42

Name of Owner

Labor and Mat'l. Report

19 49

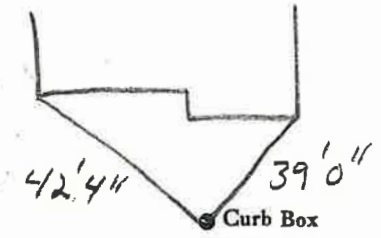

6" Main

Elev. of Main at tap 5'

Gate at ●

● Gate at

● Curb Box