

LABOR AND MATERIALS


Copper Lead	Connection	3/4		\$ 2.87
Curb	Cock Valve	3/4 in.		\$ 3.62
Service box	Old returned	Short 3 1/2 X 4 1/2 Long 4 1/2 X 5 1/2 Buff or Rdway		\$ 4.68
25 Ft.	3/4 in.	Copper C.I. C.I.	Pipe at 32	\$ 8.00
Nipples	in. at			\$
Bushings	to in. at			\$
Inc'g	Coupl'gs to in. at			\$
Union	in. at			\$
Meter	in. at			\$
Lead Joints	at			\$
Compound Joints	at			\$
Hrs. Water Maint. Man-1	at			\$
2 Hrs. Water Maint. Man-2	at 1.02			\$ 2.04
7 Hrs. Labor	at 91			\$ 6.37
Hrs. Labor	at			\$
Hrs. Compressor	at			\$
Compensation Ins.	at \$ 2.18 per C			\$ 18
Trucking				\$ 2.00
Pav't Patch				\$
<i>Taps by Messinger</i>				\$
O'head				\$
				<u>\$ 29.76</u>

58?

St.  
Pl.  
Ave. No.

Name of Owner  
*S. Walker*

Labor and Mat'l. Report *July 21* 19 *49*

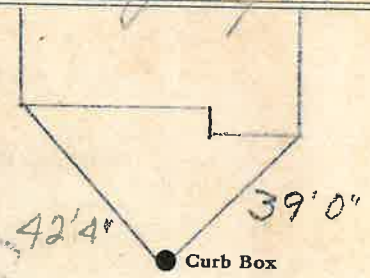

Main Elev. of Main at tap  
Gate at ● Gate at ●

● Curb Box