

LABOR AND MATERIALS


1	Copper Lead	Connection	$\frac{3}{4}$		\$	
1	Curb	Cock Valve T.S. & V.	$\frac{3}{4}$ in.		\$	
1	Service box Old returned	Short $3\frac{1}{2} \times 4\frac{1}{2}$ Long $4\frac{1}{2} \times 5\frac{1}{2}$ Buff or Rdway	$\frac{3}{4}$		\$	
8	Ft.	Copper C.I. C.I.	$\frac{3}{4}$ in.	Pipe at	\$	
	Nipples	in.		at	\$	
	Bushings	to	in.	at	\$	
	Red'g Inc'g	Coupl'gs	to	in.	\$	
	Union	in.		at	\$	
	Meter	in.		at	\$	
	Lead Joints			at	\$	
	Compound Joints			at	\$	
	Maintenance Foreman			at	\$	
	Hrs. Water Maint. Man—1			at	\$	
	Hrs. Water Maint. Man—2			at	\$	
	Hrs. Garage Foreman			at	\$	
	Hrs. Labor—			at	\$	
	Hrs. Compressor			at	\$	
	Compensation Ins. at \$			per C	\$	
	Trucking				\$	
	Pav't Patch				\$	
	TAP BY MILLER				\$	
	O'head				\$	

St.
Pl.
Ave. No. 7-9

ARBOR DRIVE

Name of Owner

Labor and Mat'l. Report JUNE 25 1948

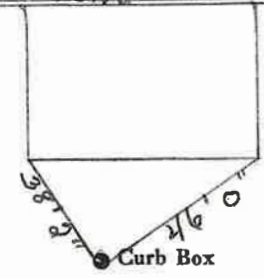

6" Main Elev. of Main at tap 5'

Gate at ● ● Gate at

● Curb Box