


LABOR AND MATERIALS

1	Copper Lead	Connection	$\frac{3}{4}$ "	\$	_____	
	Curb	Cock Valve	} $\frac{3}{4}$ in.	\$	_____	
		T.S. & V.				
1	Service box	} Short $3\frac{1}{2}$ x $4\frac{1}{2}$ Long $4\frac{1}{2}$ x $5\frac{1}{2}$ Buff or Rdway		\$	_____	
	Old returned					
27	Ft. $\frac{3}{4}$ in.		Copper G.I. Pipe	at	\$	_____
	Nipples	in.	at	\$	_____	
	Bushings	to	in.	at	\$	
	Red'g Inc'g	Coupl'gs	to	in.	at	\$
	Union	in.	at	\$	_____	
	Meter	in.	at	\$	_____	
	Lead Joints	at		\$	_____	
	Compound Joints	at		\$	_____	
	Maintenance Foreman			\$	_____	
	Hrs. Water Maint. Man-1	at		\$	_____	
	Hrs. Water Maint. Man-2	at		\$	_____	
	Hrs. Garage Foreman	at		\$	_____	
	Hrs. Labor	at		\$	_____	
	Hrs. Compressor	at		\$	_____	
	Compensation Ins.	at \$	per C	\$	_____	
	Trucking			\$	_____	
	Pav't Patch			\$	_____	
	TAP BY GIFFORD & CO			\$	_____	
	O'head			\$	_____	
				\$	_____	

ARBOR DRIVE St. Pt. Ave. No. 10-12

Name of Owner _____
TAX ID # 302.11-6-24

Labor and Mat'l. Report FEB. 4 1957

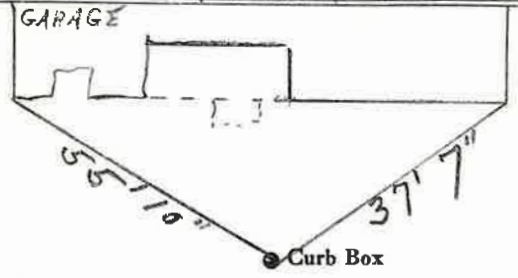

6" Main Elev. of Main at tap 5 1/2

Gate at ● ● Gate at

● Curb Box