


LABOR AND MATERIALS

1	Copper	Connection	3/4"	\$
1	Curb	Cock Valve T.S. & V.	3/4 in. ORISEAL	\$
1	Service box	Short 3 1/2 x 4 1/2		\$
	Old returned	Long 4 1/2 x 5 1/2		\$
		<del>Box - Bulwark</del>		\$
8	Ft. 3/4 in.	Copper Pipe at		\$
		Galv.		\$
		Galv.		\$
	Nipples	in. at		\$
	Bushings	to in. at		\$
	Red'g			\$
	Inc'g	Coupl'gs. to in. at		\$
	Union	in. at		\$
	Meter	in. at		\$
	Lead Joints	at		\$
	Compound Joints	at		\$
	Maintenance Foreman			\$
	Hrs. Water Maint. Man-1	at		\$
	Hrs. Water Maint. Man-2	at		\$
	Hrs. Garage Foreman	at		\$
	Hrs. Labor	at		\$
	Hrs. Compressor	at		\$
	Compensation Ins. at \$	per C		\$
	Trucking			\$
	Pav't Patch			\$
	TAP BY GIERGRO + CO			\$
	4-7-64			\$
	O'head			\$

ARBOR DRIVE SE. PT. Ave. No. 11

Name of Owner

Labor and Mat'l. Report APR. 7 1964

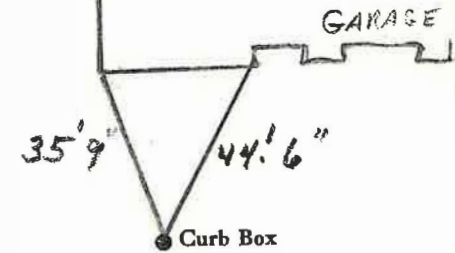

6" Main

Elev. of Main at tap 5'

Gate at •

• Gate at

• Curb Box