

LABOR AND MATERIALS

Copper	} Connection		\$
Lead			
Curb	} Cock Valve T. S. & V. }	in.	\$
Service box	} Short 3½ x 4½ } Long 4½ x 5½ }		\$
Old returned			
51 Ft. 3/4 in.	} Copper G.I. C.I. }	Pipe at	\$
Nipples	in. at		\$
Bushings	to in. at		\$
Red'g	} Coupl'gs	to in. at	\$
Inc'g			
Union	in. at		\$
Meter	in. at		\$
			\$
Compound Joints	at		\$
Maintenance Foreman			\$
Hrs. Water Maint. Man—1	at		\$
Hrs. Water Maint. Man—2	at		\$
Hrs. Garage Foreman	at		\$
Hrs. Labor	at		\$
Hrs. Compressor	at		\$
			\$
Trucking			\$
Pav't Patch			\$
			\$
			\$
			\$
			\$

419'


18 Arlington

St. Pl. Ave. No. 18

Name of Owner

Labor and Mat'l. Report

1987

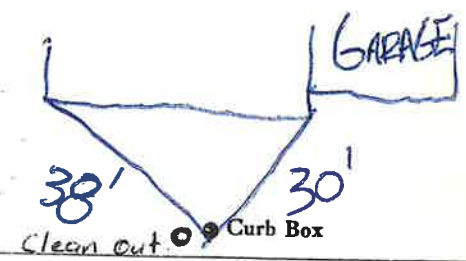

Main

Elev. of Main at tap

Gate at ●

● Gate at

● Curb Box