

LABOR AND MATERIALS

Copper	} Connection	_____	\$ _____	
Lead				
Curb	} Cock } Valve } T. S. & V.	_____ in.	\$ _____	
Service box		} Short 3 1/2 x 4 1/2 } Long 4 1/2 x 5 1/2	_____	\$ _____
Old returned				
45' 34" Ft.	} Copper } G.I. } G.I.	_____ in.	\$ _____	
Nipples	_____ in.	at _____	\$ _____	
Bushings	_____ to _____	in. at _____	\$ _____	
Red'g	} Coupl'gs	_____ to _____	in. at _____	\$ _____
Inc'g				
Union	_____ in.	at _____	\$ _____	
Meter	_____ in.	at _____	\$ _____	
			\$ _____	
Compound Joints	at _____		\$ _____	
Maintenance Foreman			\$ _____	
Hrs. Water Maint. Man—1	at _____		\$ _____	
Hrs. Water Maint. Man—2	at _____		\$ _____	
Hrs. Garage Foreman	at _____		\$ _____	
Hrs. Labor—	at _____		\$ _____	
Hrs. Compressor	at _____		\$ _____	
			\$ _____	
Trucking			\$ _____	
Pav't Patch			\$ _____	
			\$ _____	
			\$ _____	
			\$ _____	


22 Astington

St. Pl. Ave. No. 22

Name of Owner

Labor and Mat'l. Report

Oct 1987

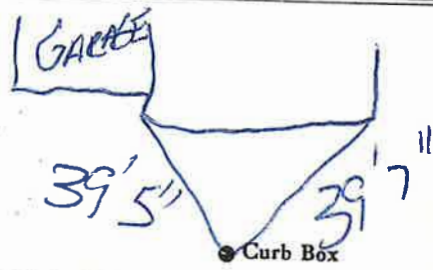

8" Main

Elev. of Main at tap

Gate at ●

● Gate at

● Curb Box