

OK


6 Arlington

St. Pl. Ave. No. 6

Name of Owner

Labor and Mat'l. Report

1-18-1938

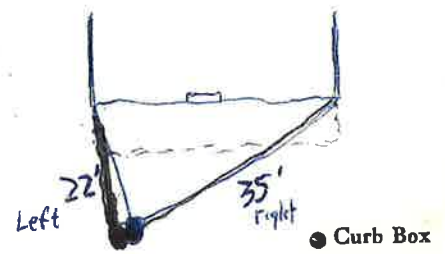

8" Main

Elev. of Main at tap 5'

Gate at

Gate at

Curb Box

LSM-5C-6-1-67

LABOR AND MATERIALS

Copper	Connection	_____	\$			
Lead						
Curb	Cock Valve T. S. & V.	_____ in.	\$			
				Service box	Short 3 1/2 x 4 1/2 Long 4 1/2 x 5 1/2	_____ \$
				Old returned		
Ft. 3/4 in.	Copper G.I. G.I.	Pipe at	\$			
Nipples	_____ in.	at	\$			
Bushings	_____ to _____ in.	at	\$			
Red'g Inc'g	Coupl'gs	_____ to _____ in.	at	\$		
Union					_____ in.	at
Meter	_____ in.	at	\$			
			\$			
	Compound Joints	at	\$			
	Maintenance Foreman		\$			
	Hrs. Water Maint. Man-1	at	\$			
	Hrs. Water Maint. Man-2	at	\$			
	Hrs. Garage Foreman	at	\$			
	Hrs. Labor	at	\$			
	Hrs. Compressor	at	\$			
			\$			
	Trucking		\$			
	Pav't Patch		\$			
			\$			
			\$			
			\$			
			\$			