

**LABOR AND MATERIALS**

Copper	} Connection	_____	\$ _____	
Lead				
Curb	} Cock } Valve } T. S. & V.	_____ in.	\$ _____	
		} Service box	} Short 3½ x 4½	\$ _____
Ft. 3/4 in.	} Copper } G.I. } C.I.	Pipe at	\$ _____	
Nipples _____ in.		at	\$ _____	
Bushings _____ to _____ in.		at	\$ _____	
Red'g	} Coupl'gs	_____ to _____ in.	at	\$ _____
Inc'g				
Union _____ in.	at	\$ _____		
Meter _____ in.	at	\$ _____		
_____			\$ _____	
Compound Joints	at	\$ _____		
Maintenance Foreman		\$ _____		
Hrs. Water Maint. Man-1	at	\$ _____		
Hrs. Water Maint. Man-2	at	\$ _____		
Hrs. Garage Foreman	at	\$ _____		
Hrs. Labor	at	\$ _____		
Hrs. Compressor	at	\$ _____		
_____			\$ _____	
Trucking		\$ _____		
Pav't Patch		\$ _____		
_____		\$ _____		
_____		\$ _____		
_____		\$ _____		
_____		\$ _____		


St.  
Pt.  
Ave. No. 10

10 Arlington

Name of Owner \_\_\_\_\_

Labor and Mat'l. Report

19 90

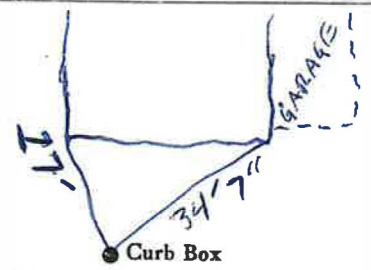

8" Main

Elev. of Main at tap \_\_\_\_\_

Gate at ●

● Gate at

● Curb Box

LSM-5C-6-1-67