

LABOR AND MATERIALS

Copper	} Connection	_____	\$ _____	
Lead				
Curb	} Cock	} _____ in.	\$ _____	
				} Valve
Service box	} Short 3½ x 4½	} _____	\$ _____	
Old returned				Long 4½ x 5½
6 Ft. 3/4 in.	} Copper	} Pipe at _____	\$ _____	
				} G. I.
Nipples	_____ in. at _____	\$ _____		
Bushings	_____ to _____ in. at _____	\$ _____		
Red'g	} Coupl'gs _____ to _____ in. at _____	\$ _____		
Inc'g				
Union	_____ in. at _____	\$ _____		
Meter	_____ in. at _____	\$ _____		
_____		\$ _____		
Compound Joints	at _____	\$ _____		
Maintenance Foreman		\$ _____		
Hrs. Water Maint. Man-1	at _____	\$ _____		
Hrs. Water Maint. Man-2	at _____	\$ _____		
Hrs. Garage Foreman	at _____	\$ _____		
Hrs. Labor	at _____	\$ _____		
Hrs. Compressor	at _____	\$ _____		
_____		\$ _____		
Trucking		\$ _____		
Pav't Patch		\$ _____		
_____		\$ _____		
_____		\$ _____		
_____		\$ _____		
_____		\$ _____		

Arlington


St. 15th
 Pt. 47th
 Ave. No.

Name of Owner

Vesey

Labor and Mat'l. Report

1991

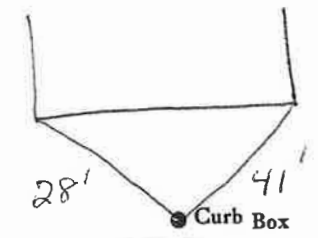

_____ Main Elev. of Main at tap _____

Gate at ●

● Gate at

● Curb Box