

LABOR AND MATERIALS


Copper	} Connection	_____	\$			
Lead		_____	\$			
Curb	} Cock Valve T. S. & V.	} _____ in.	\$			
				Service box	} Short 3½ x 4½	}
Old returned		_____	\$			
Ft. _____ in.	} Copper G. I. C. I.	} Pipe at _____	\$			
Nipples _____ in.				at _____	\$	
Bushings _____ to _____ in.				at _____	\$	
Red'g } Inc'g }	} Coupl'gs _____ to _____ in.	at _____	\$			
Union _____ in.				at _____	\$	
Meter _____ in.	at _____	\$				
_____		_____	\$			
Compound Joints	at _____	\$				
Maintenance Foreman	_____	\$				
Hrs. Water Maint. Man—1	at _____	\$				
Hrs. Water Maint. Man—2	at _____	\$				
Hrs. Garage Foreman	at _____	\$				
Hrs. Labor—	at _____	\$				
Hrs. Compressor	at _____	\$				
_____		_____	\$			
Trucking	_____	\$				
Pav't Patch	_____	\$				
_____		_____	\$			
_____		_____	\$			
-St-  
-Pt-  
Ave. No. 11

ASH

Name of Owner \_\_\_\_\_

Labor and Mat'l. Report \_\_\_\_\_ 19

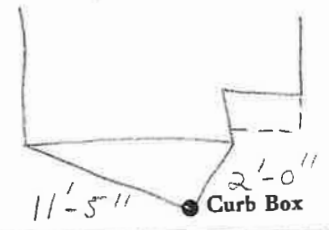

Elev. of  
Main at tap \_\_\_\_\_

\_\_\_\_\_ Main \_\_\_\_\_

Gate at ● \_\_\_\_\_ ● Gate at \_\_\_\_\_

● Curb Box